		ITEM 1 PER ENGINEERING DEVELOPMENT.
2		1. EXTENDED HULL APPLICABILITY TO INCLUDE HULL
		2. THIS REVISION REFLECTS AS-BUILT CONDITIONS
		ITEM 1 & 2 PER ENGINEERING DEVELOPMENT.

FRM_88 FRM_86 FRM_84 FRM_82 FRM_80 FRM_78 FRM_76

90 85 80

65M ABL
IN DECK
ABL
BASELINE

DOCUME		
DATE IN ROOM	9/4/03	
ISSUE DATE	9/5/03	5/27/05
REV#	0	1
PROJECT ENG	1	1
PROJECT MGR	1	1
ABS		
USPH		
USCG		
HMP PC		
PROD DESIGN GROUP		
HULL MGR		
HULL LEAD	(1)	(1
HVAC		
JOINER		
HPG PC		
NOISE CONT		
CHAND LLC		
ISSUED BY	AE	A

PROFILE

STBD SIDE SHOWN, PORT SIM EXCEPT AS NOTED

HULL APPLICABILITY

A1

This drawing, design concept and specifications are the property of VT Halter Marine, Inc. and are furnished on a confidential basis with an expressed understanding that

VT Halter Marine, Inc.
Vision Technologies Systems

DRAWN BY	ABS APPV
WH 7/14/03	
CHECKED BY	USCG APPV

VESSEL
FRV40 CLASS 63m

TITLE
SHEL

REVISIONS				
REV	ZONE	DESCRIPTION	DATE	APPROVED
1		1. EXTENDED HULL APPLICABILITY TO INCLUDE HULL 1956. ITEM 1 PER ENGINEERING DEVELOPMENT.	5/24/05 AGE	5/27/05 FH
2		1. EXTENDED HULL APPLICABILITY TO INCLUDE HULL 1957. 2. THIS REVISION REFLECTS AS-BUILT CONDITIONS FOR HULL 1953. ITEM 1 & 2 PER ENGINEERING DEVELOPMENT.	8/28/06 MDP	

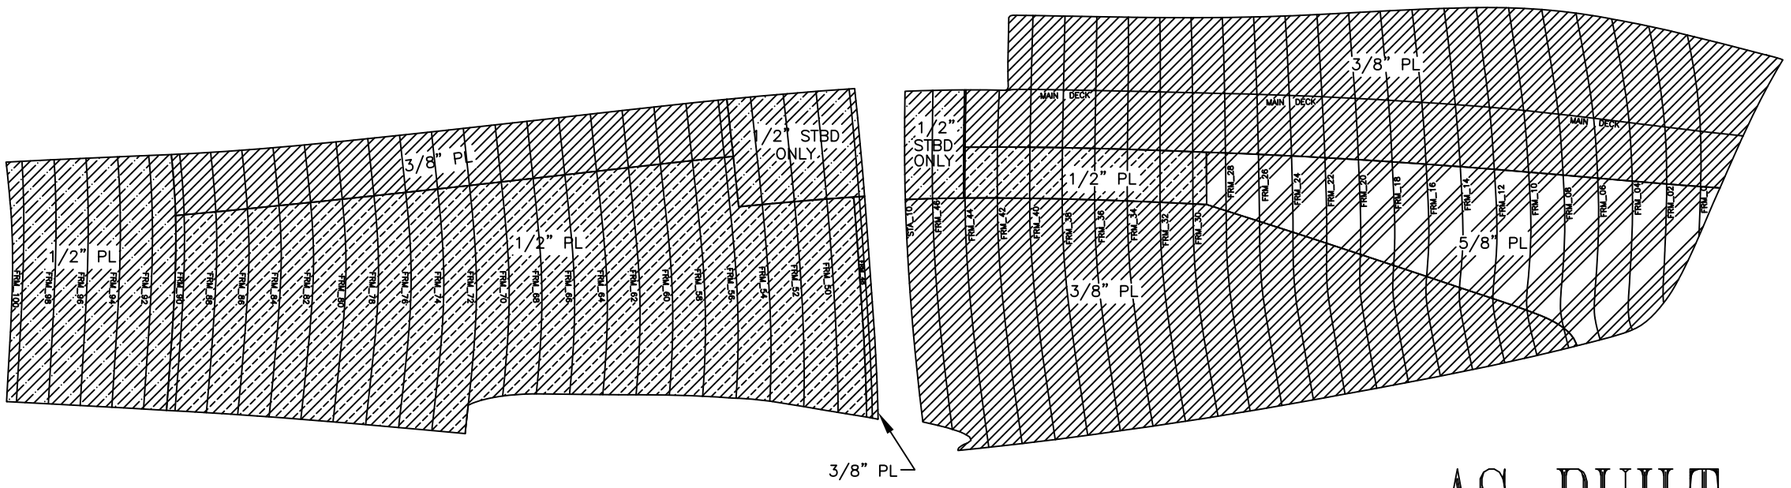

SHELL EXPANSION

STBD SIDE SHOWN, PORT SIM EXCEPT AS NOTED

AS-BUILT

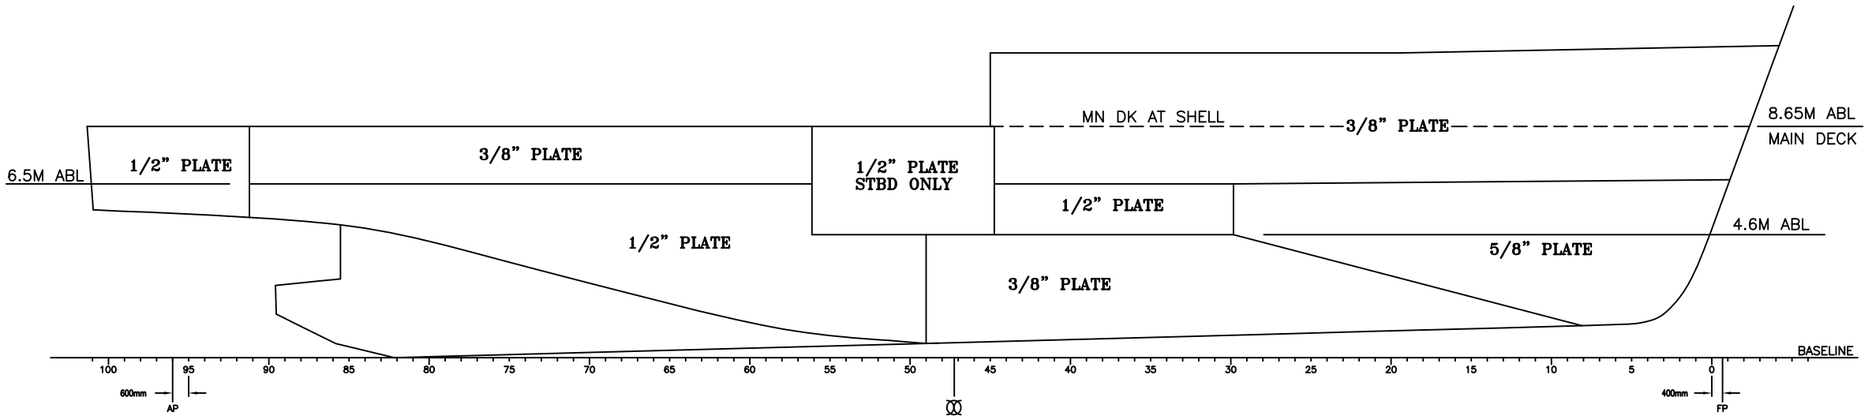

PROFILE

STBD SIDE SHOWN, PORT SIM EXCEPT AS NOTED

DOCUMENT DISTRIBUTION RECORD			
DATE IN ROOM	9/4/03	5/25/05	8/28/06
ISSUE DATE	9/5/03	5/27/05	5/25/06
REV#	0	1	2
PROJECT ENG	1	1	
PROJECT MGR	1	1	
ABS			
USPH			
USCG			
HMP PC			1
PROD DESIGN GROUP			
HULL MGR			
HULL LEAD	(1)	(1)	1
HVAC			
JOINER			
HPG PC			1
NOISE CONT			
CHAND LLC			
ISSUED BY	AE	AE	

HULL APPLICABILITY

1 M282 HULL 1953
2 M283 HULL 1956
2 M284 HULL 1957

10	9	8	7	6	5	4	3	2	1	REV
										SHT

REVISION STATUS

This drawing, design concept and specifications are the property of VT Halter Marine, Inc. and are furnished on a confidential basis with an expressed understanding that they will not be copied in any manner, used for manufacture, sold, transferred, nor used to the detriment of said firm without written permission. The recipient further agrees not to disclose these contents hereof to any other parties except for those specific purposes for which this drawing was issued.

VT Halter Marine, Inc.
Vision Technologies Systems

DRAWN BY	WH 7/14/03	ABS APPV
CHECKED BY	AGE 7/14/03	USCG APPV
APPROVED BY	JCO 9/3/03	OWNER APPV
HULL NO	APPLICABILITY	CAGE CODE 3B213
SIZE	D	
ESTIMATE NO	00-104	SCALE 1:100

VESSEL: FRV40 CLASS 63m FISHERIES RESEARCH VESSEL

TITLE: SHELL EXPANSION

JOB NO.	ITEM	DELIVERABLE	SHEET	REV
M282	085	FC02	001	02

FILE: R:\M282\FUNCTIONALDESIGN\INWORK\HULLDWGS | SHEET 1 OF 1 | PLOT: 1:100

SH: 1
DWG NO. M282-085-FC02